



L E G E N D Indicates street line heretofore established and hereby retained. Indicates street line heretofore established and hereby eliminated. Indicates street line hereby established. Indicates sidewalk and roadway treatment line hereby established or heretofore established and hereby retained. 284.15 Indicates dimension heretofore established and hereby retained. 448.72 Indicates dimension hereby established. <del>-106.04</del> Indicates dimension heretofore established and hereby eliminated. <u>13.52</u> Indicates elevation hereby established. <del>21.27</del> Indicates elevation heretofore established and hereby eliminated. Indicates sidewalk and roadway treatment dimension hereby established. Indicates sidewalk and roadway treatment dimension heretofore established and hereby retained. <u>186.59</u>' Indicates tie—in distance hereby established. 115.14 Indicates tie-in distance heretofore established and hereby retained. <del>16.28'</del> Indicates tie-in distance heretofore established and hereby eliminated. 21.27 Indicates elevation heretofore established and hereby eliminated. Indicates elevation hereby established. Indicates elevation heretofore established and hereby retained. 28.12 U.S. Pierhead and Bulkhead Line ELEVATIONS SHOWN ON THIS MAP ARE FOR TOP OF PAVEMENT AT CENTER LINE OF ROADWAY AND ARE REFERRED TO THE BELMONT ISLAND DATUM

WHICH IS 2.265 FEET BELOW THE U.S.C.&G DATUM AT SANDY HOOK, NJ

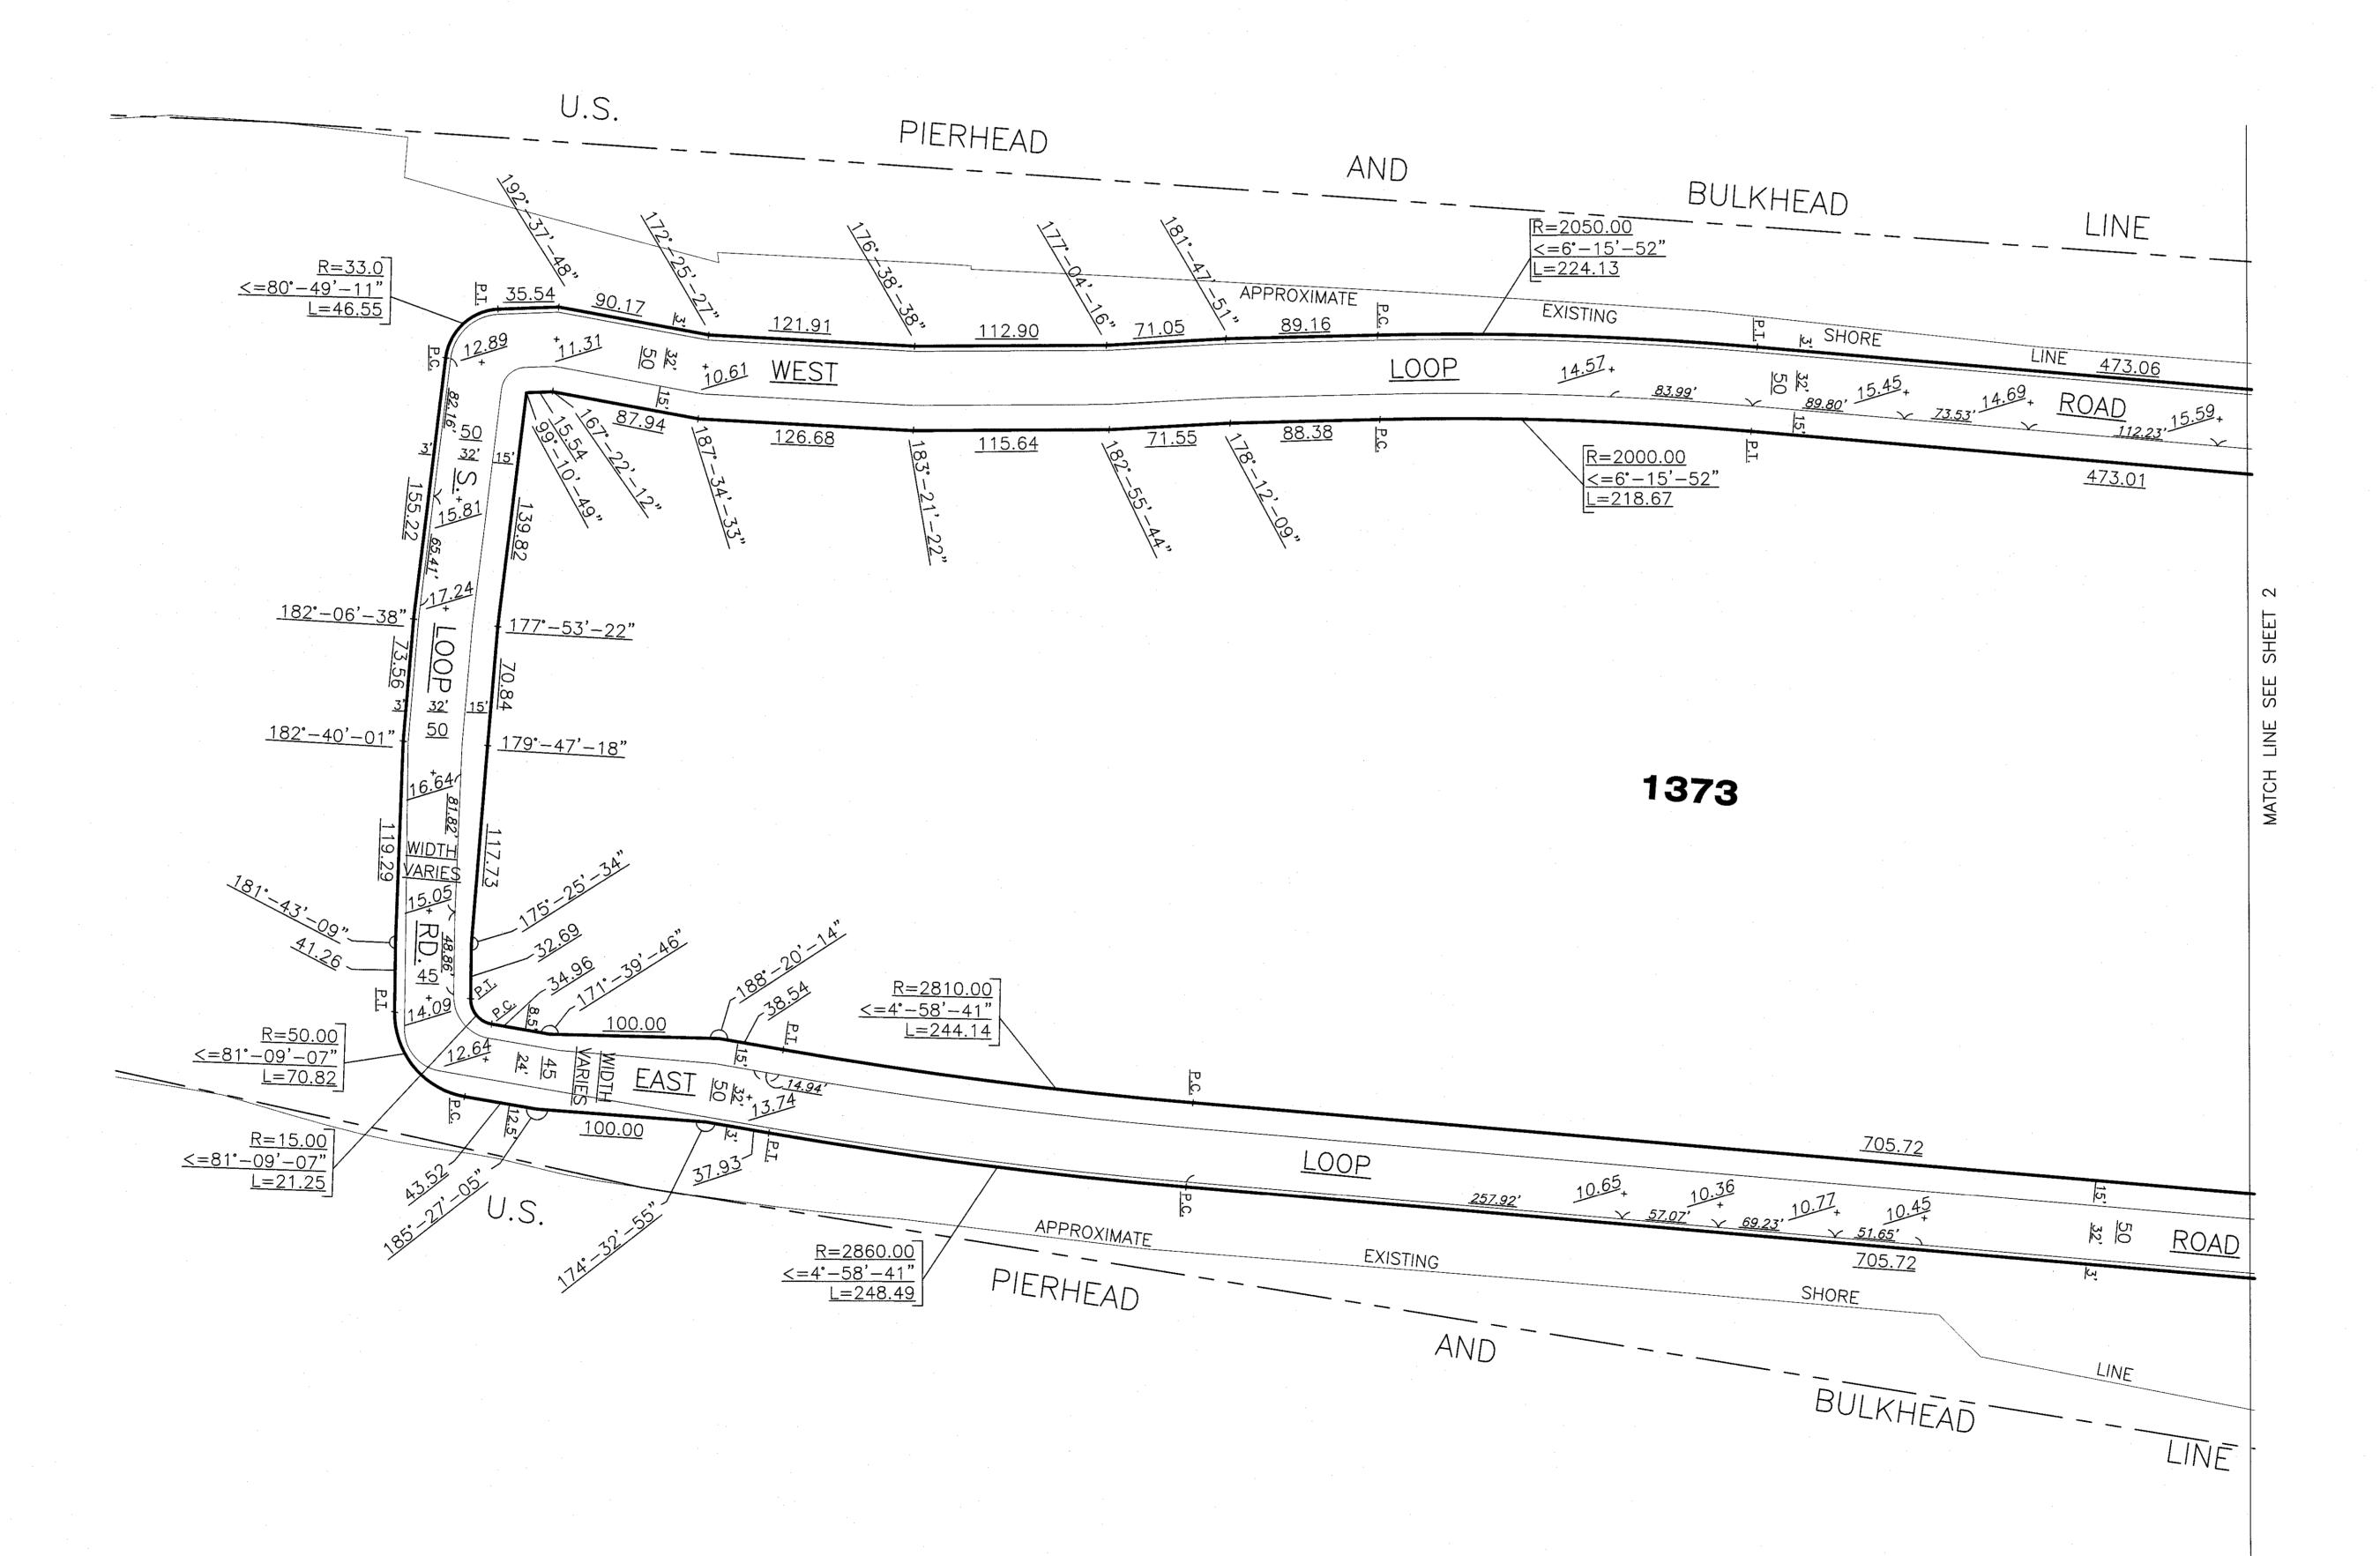

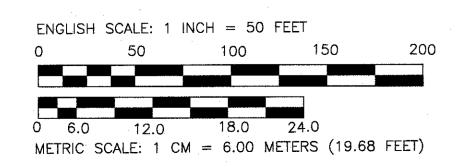

### CORNELLNYC TECH CITY MAP CHANGE

ROOSEVELT ISLAND, NEW YORK

APPLICANT: CORNELL UNIVERSITY 300 DAY HALL ITHACA, NY 14853 Tel: (607) 255-2364

ENGINEER: PHILIP HABIB & ASSOCIATES 102 MADISON AVENUE NEW YORK, NY 10016 Tel: (212) 929-5656

SURVEYOR:
GALLAS SURVEYING GROUP 171 CHURCH LANE NORTH BRUNSWICK, NJ 08902 Tel: (732) 422-6700

APPLICATION MAP

SHOWING THE ESTABLISHMENT OF STREETS SOUTH OF MAIN STREET ON ROOSEVELT ISLAND


06/26/2012


1 OF 2


CHECKED BY: S.E.M.





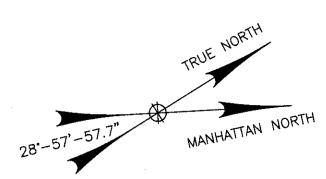

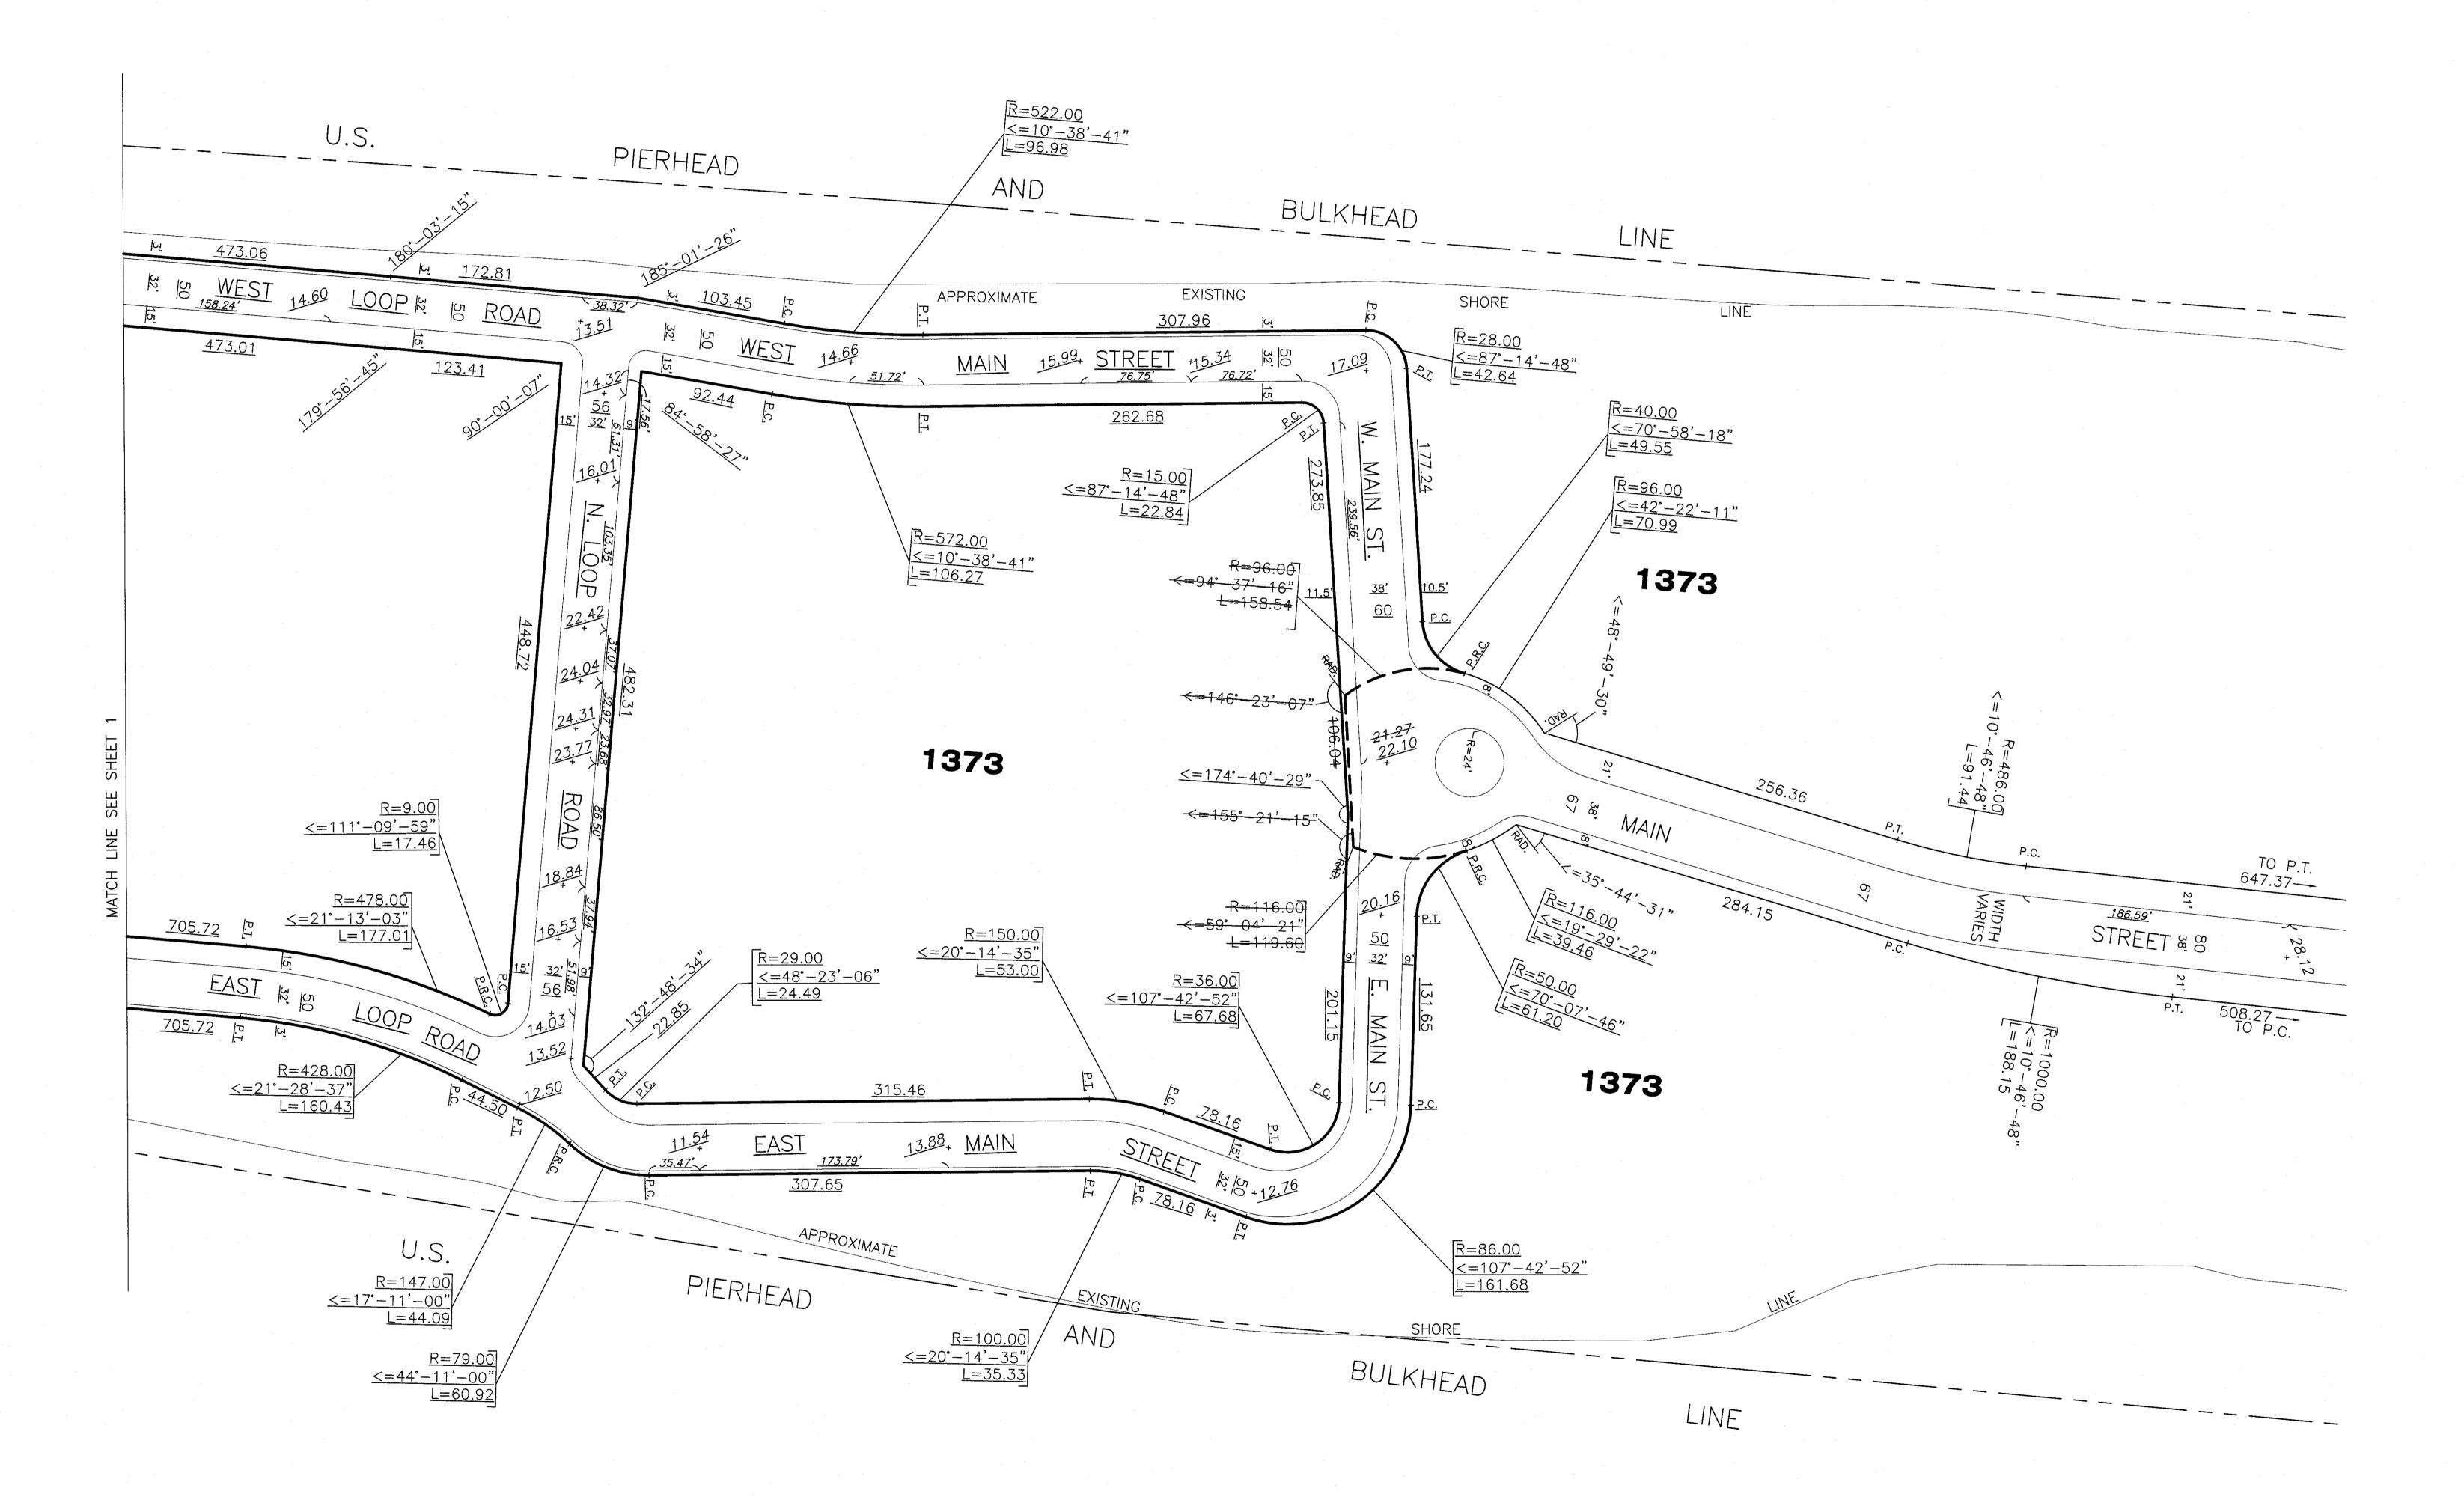

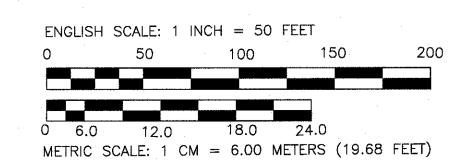

## **CORNELLNYC TECH** CITY MAP CHANGE

ROOSEVELT ISLAND, NEW YORK

APPLICANT: CORNELL UNIVERSITY 300 DAY HALL ITHACA, NY 14853 Tel: (607) 255-2364

ENGINEER:
PHILIP HABIB & ASSOCIATES 102 MADISON AVENUE NEW YORK, NY 10016 Tel: (212) 929-5656

SURVEYOR:
GALLAS SURVEYING GROUP 171 CHURCH LANE NORTH BRUNSWICK, NJ 08902 Tel: (732) 422-6700

### APPLICATION MAP

SHOWING THE ESTABLISHMENT OF STREETS SOUTH OF MAIN STREET ON ROOSEVELT ISLAND


06/26/2012

2 OF 2


CHECKED BY: S.E.M.






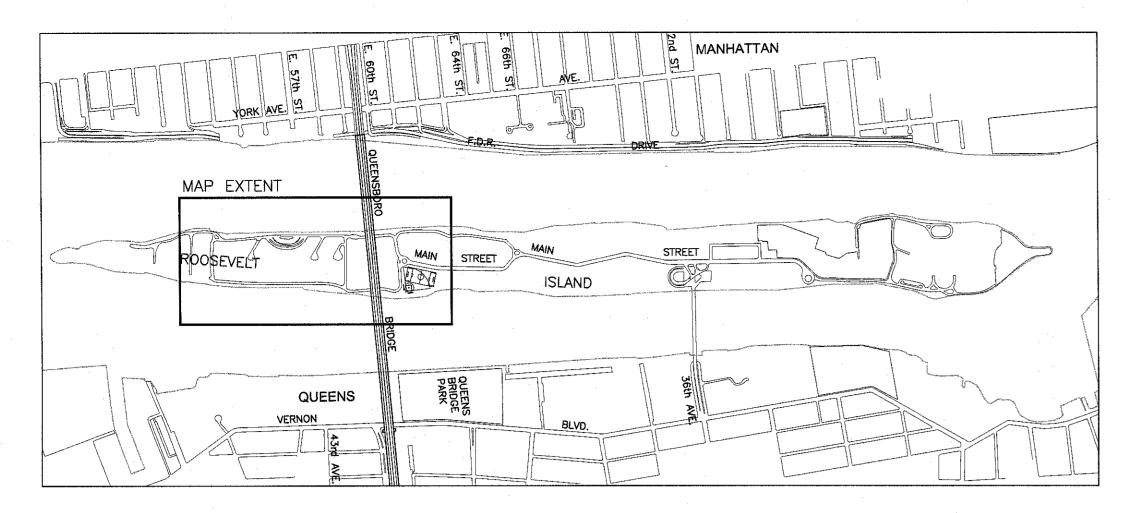

LOCATION PLAN

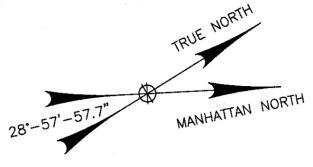

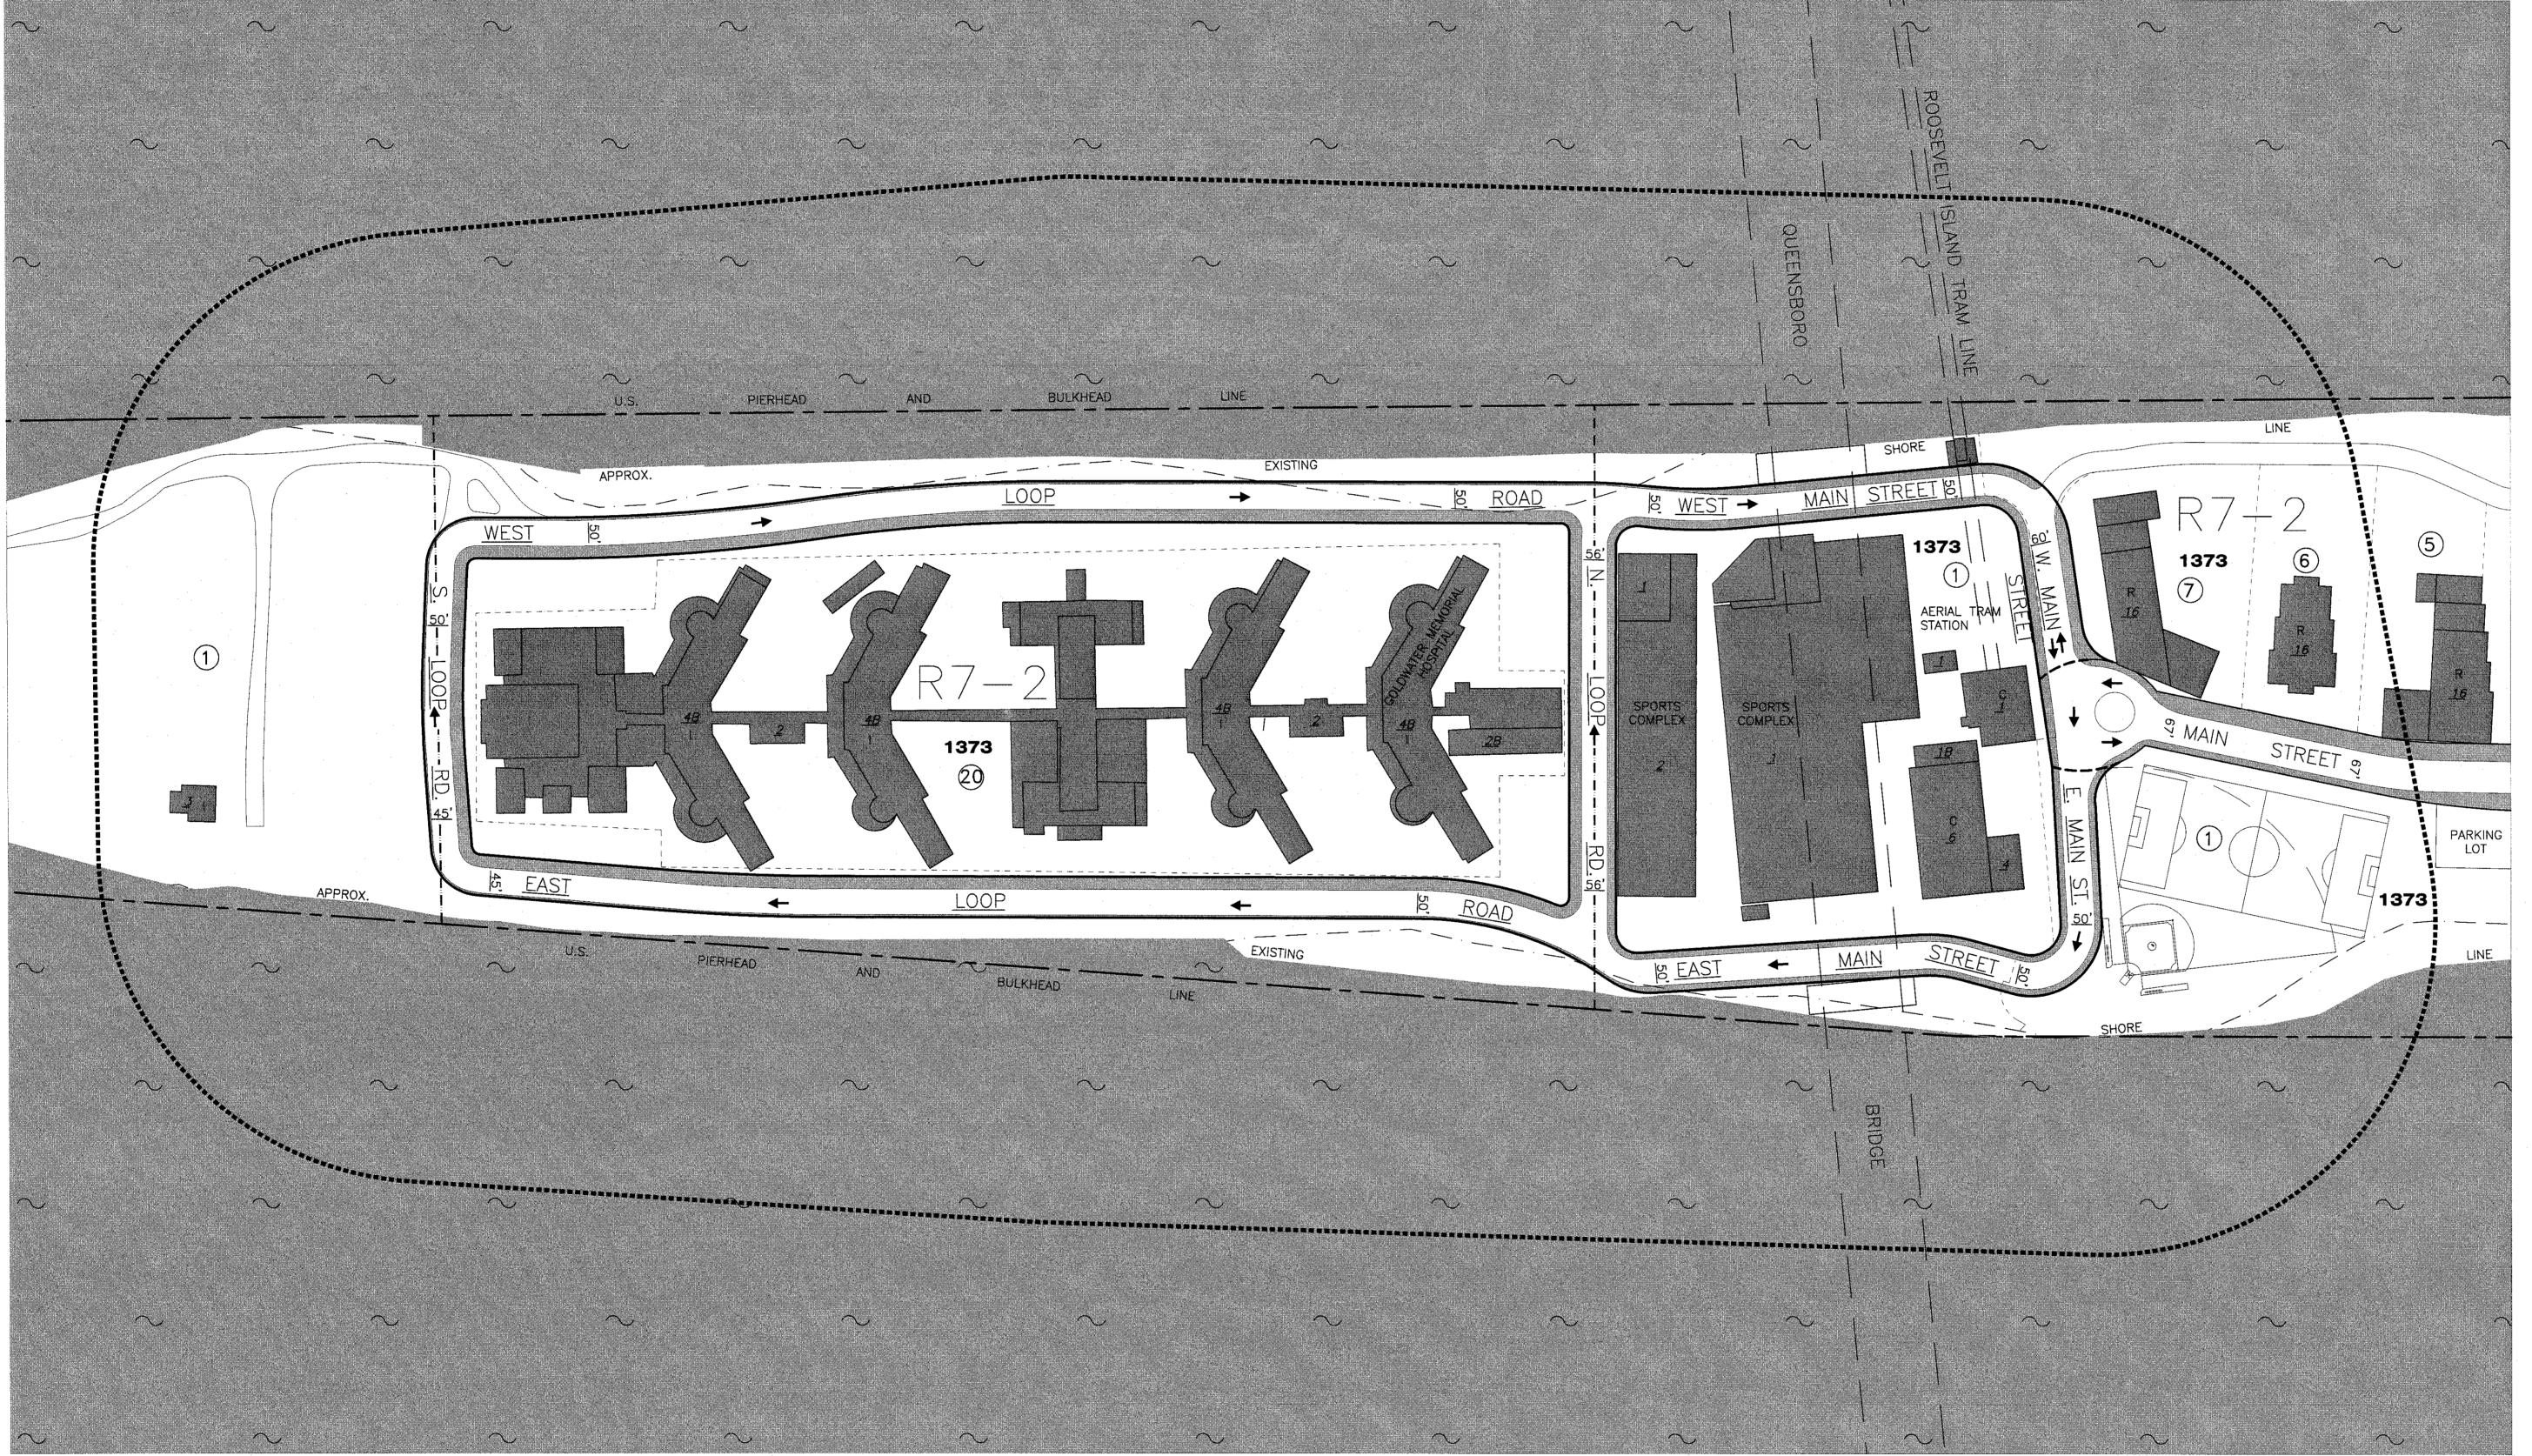

LEGEND

R7-2 existing zoning ---- STREET LINE TO BE ELIMINATED STREET LINE PROPOSED TO BE ESTABLISHED 400' RADIUS

---- BLOCK LINE

1373 BLOCK NUMBER

← VEHICULAR FLOW

(1) LOT NUMBER 2 NUMBER OF BUILDING STORIES 4B NUMBER OF BUILDING STORIES WITH BASEMENT

SIDEWALK WATER

BUILDING FOOTPRINT

C COMMERCIAL / INSTITUTIONS M MANUFACTURING

TAX LOT LINE

R RESIDENTIAL v VACANT

SCALE: 1" = 100'

# **CORNELLNYC TECH** CITY MAP CHANGE

ROOSEVELT ISLAND, NEW YORK

APPLICANT: CORNELL UNIVERSITY 300 DAY HALL ITHACA, NY 14853 Tel: (607) 255-2364

ENGINEER:
PHILIP HABIB & ASSOCIATES
102 MADISON AVENUE
NEW YORK, NY 10016
Tel: (212) 929-5656

SURVEYOR: GALLAS SURVEYING GROUP 171 CHURCH LANE NORTH BRUNSWICK, NJ 08902 Tel: (732) 422-6700

#### AREA MAP

SHOWING THE ESTABLISHMENT OF STREETS SOUTH OF MAIN STREET ON ROOSEVELT ISLAND

DATE 06/26/2012 SHEET

1 OF 1 DRAWN BY: A.Y.

