


LOCATION PLAN / BUILDING ROOF PLAN

SCALE: 1/32" = 1'-0"



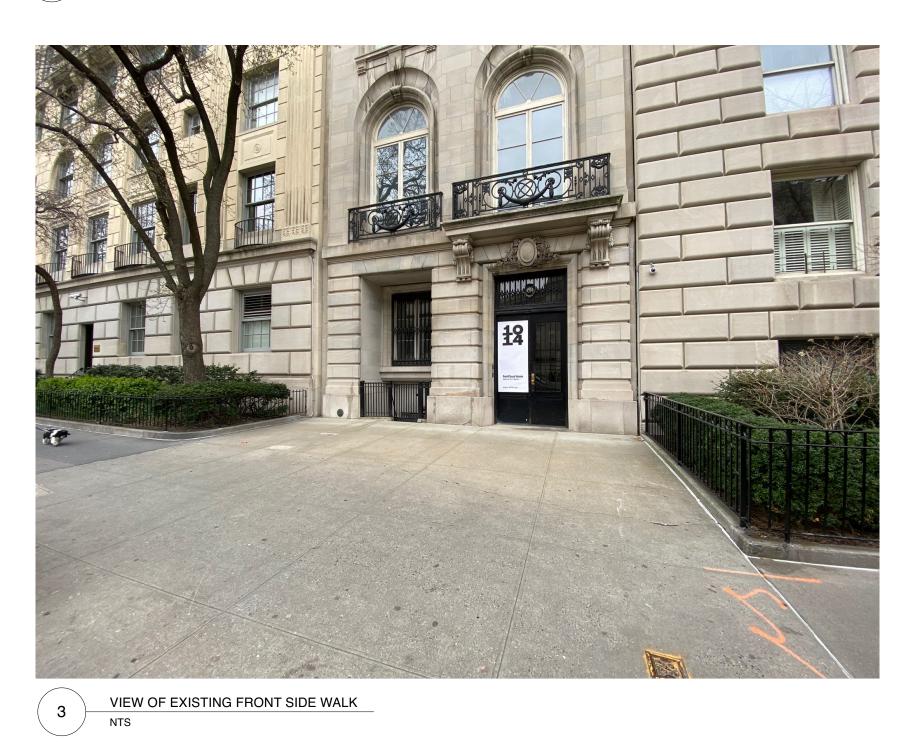

E82nd street

PLAN SHOWING LOCATION OF EGRESS STEPS AND BENCH

TO BE LOCATED AT 1014 5TH AVENUE

BOROUGH OF MANHATTAN

TO ACCOMPANY APPLICATION

DATED 01/30/2024

OF

CONSULATE GENERAL OF THE FEDERAL REPUBLIC OF GERMANY IN NEW YORK

TO THE DEPARTMENT OF TRANSPORTATION, CITY OF NEW YORK

ΒY

CONSULATE GENERAL OF THE FEDERAL REPUBLIC OF GERMANY IN NEW YORK

Carte Duple

CARSTEN RUEPKE, DEPUTY CONSUL APPLICANT

> ZONING INFORMATION: BLOCK: **1494** LOT: **72** ZONING DISTRICTS: R10,R8B ZONING MAP: 8C

CHARACTER OF MATERIALS: DOLOMITIC LIMESTONE, SANDBLASTED FINISH; **IRON GUARDRAIL AND GATE, PAINTED BLACK.**

COST OF REMOVAL AND RESTORATION: **\$ 50,000**

NOTES:

1. PROPOSED IMPROVEMENTS SHOWN IN RED. 2. ASSOCIATED VAULT LICENSES APPLICATION PENDING

ARCHITECT OF RECORD KARO ARCHITECTS 195 CHRYSTIE STREET 601D

NEW YORK, NY 10002 212 477 7010 INFO@KAROARCHITECTS.COM

DESIGN ARCHITECT DAVID CHIPPERFIELD ARCHITECTS PROJECT


1014 - SPACE FOR IDEAS 1014 5TH AVENUE NEW YORK NY 10028


PHASE DESIGN DEVELOPMENT

ISSUE / REVISION



DRAWING TITLE LOCATION PLAN, PHOTOS

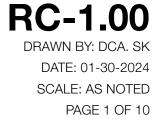

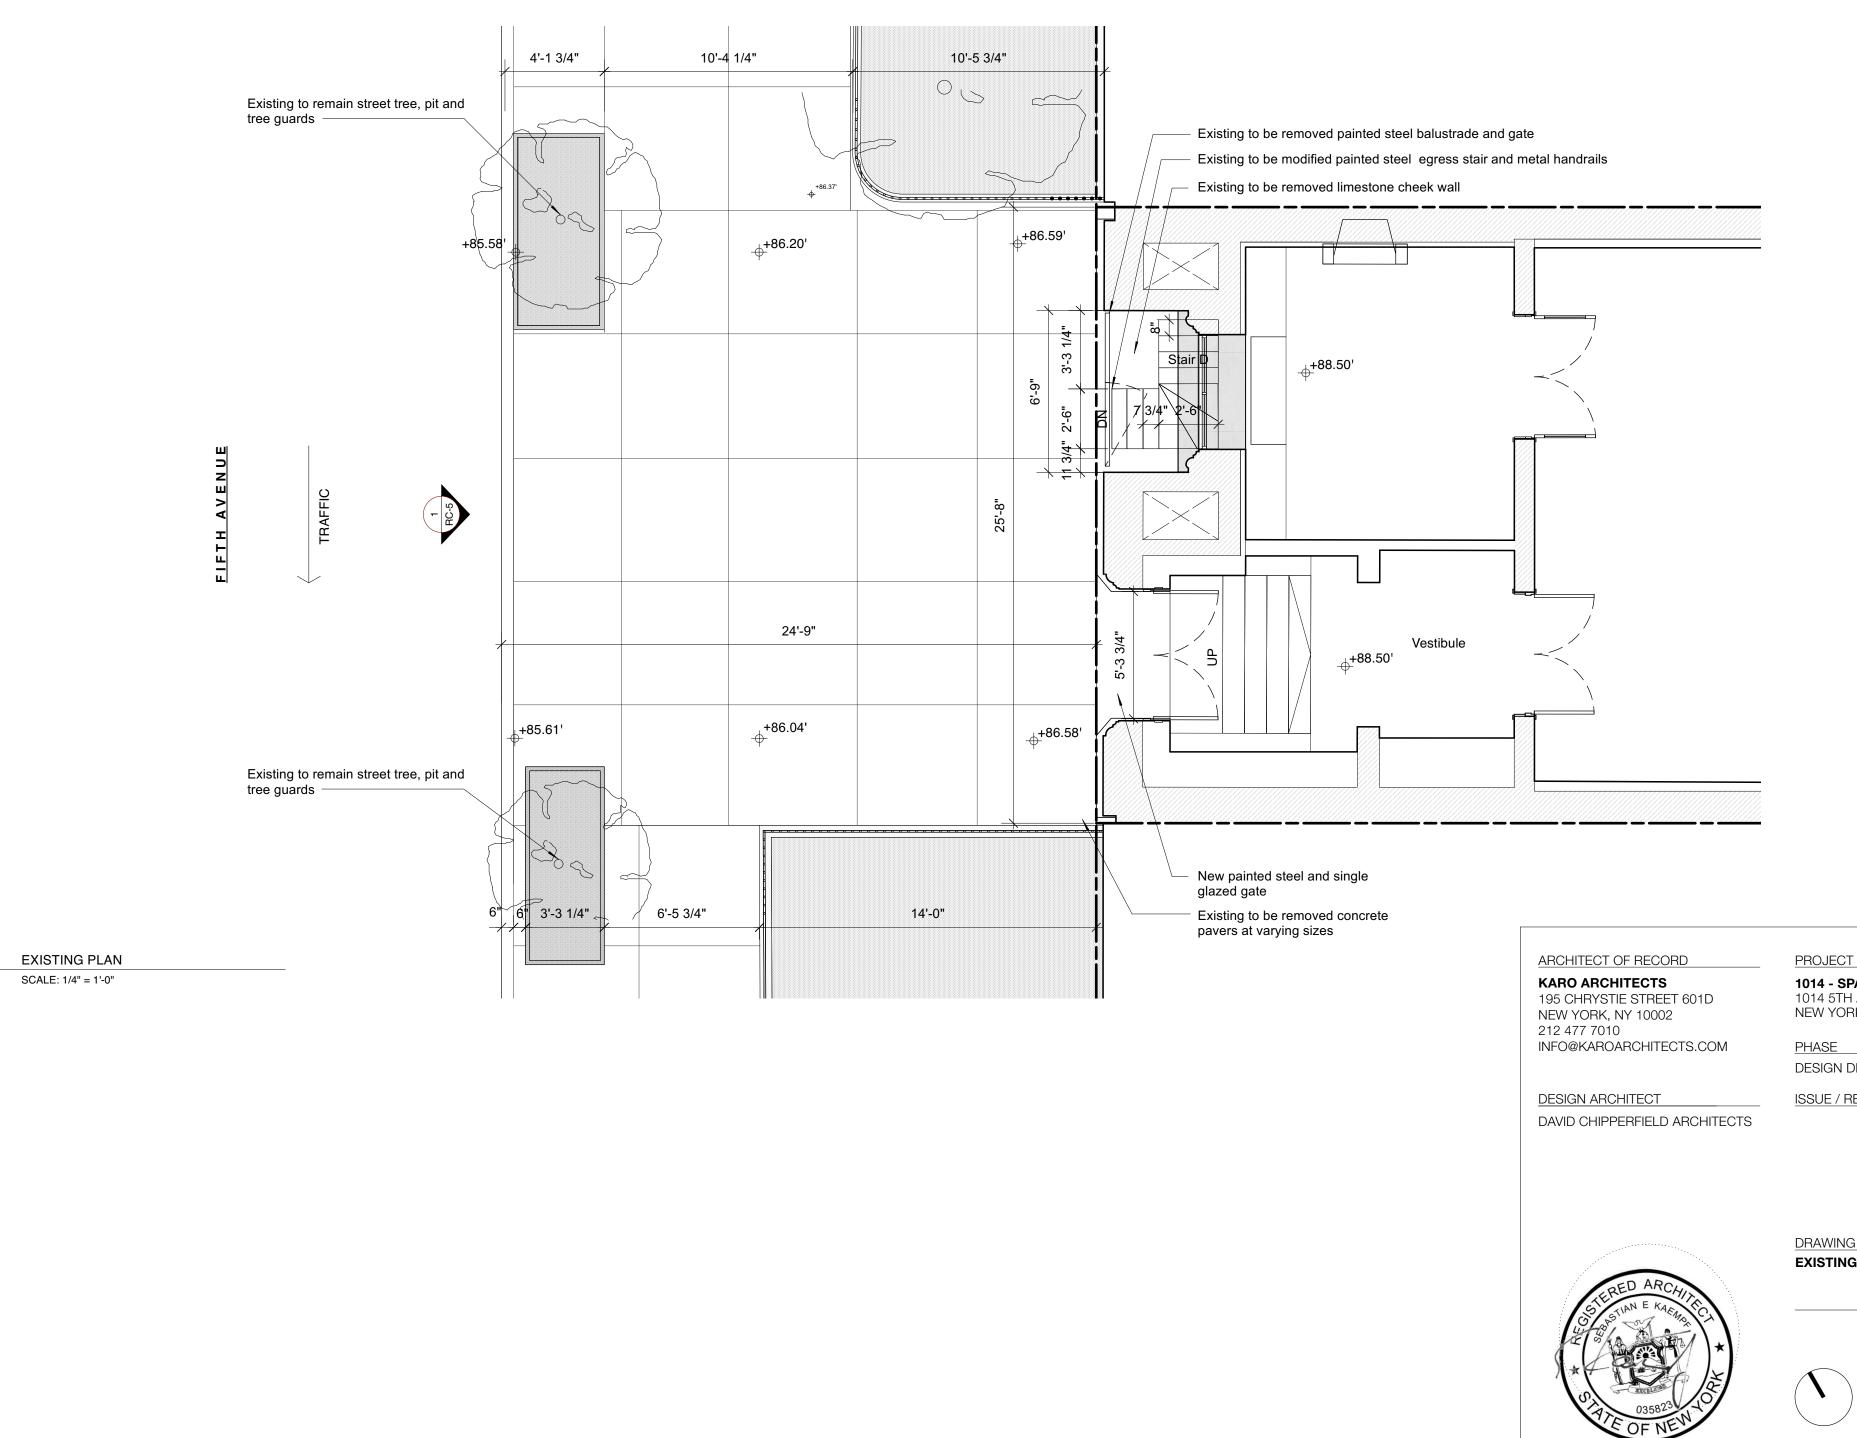


1014 - SPACE FOR IDEAS 1014 5TH AVENUE NEW YORK NY 10028


DESIGN DEVELOPMENT

ISSUE / REVISION


DRAWING TITLE EXISTING GROUND FLOOR PLAN

> **RC-2.00** DRAWN BY: DCA, SK DATE: 01-30-2024 SCALE: AS NOTED PAGE 2 OF 10

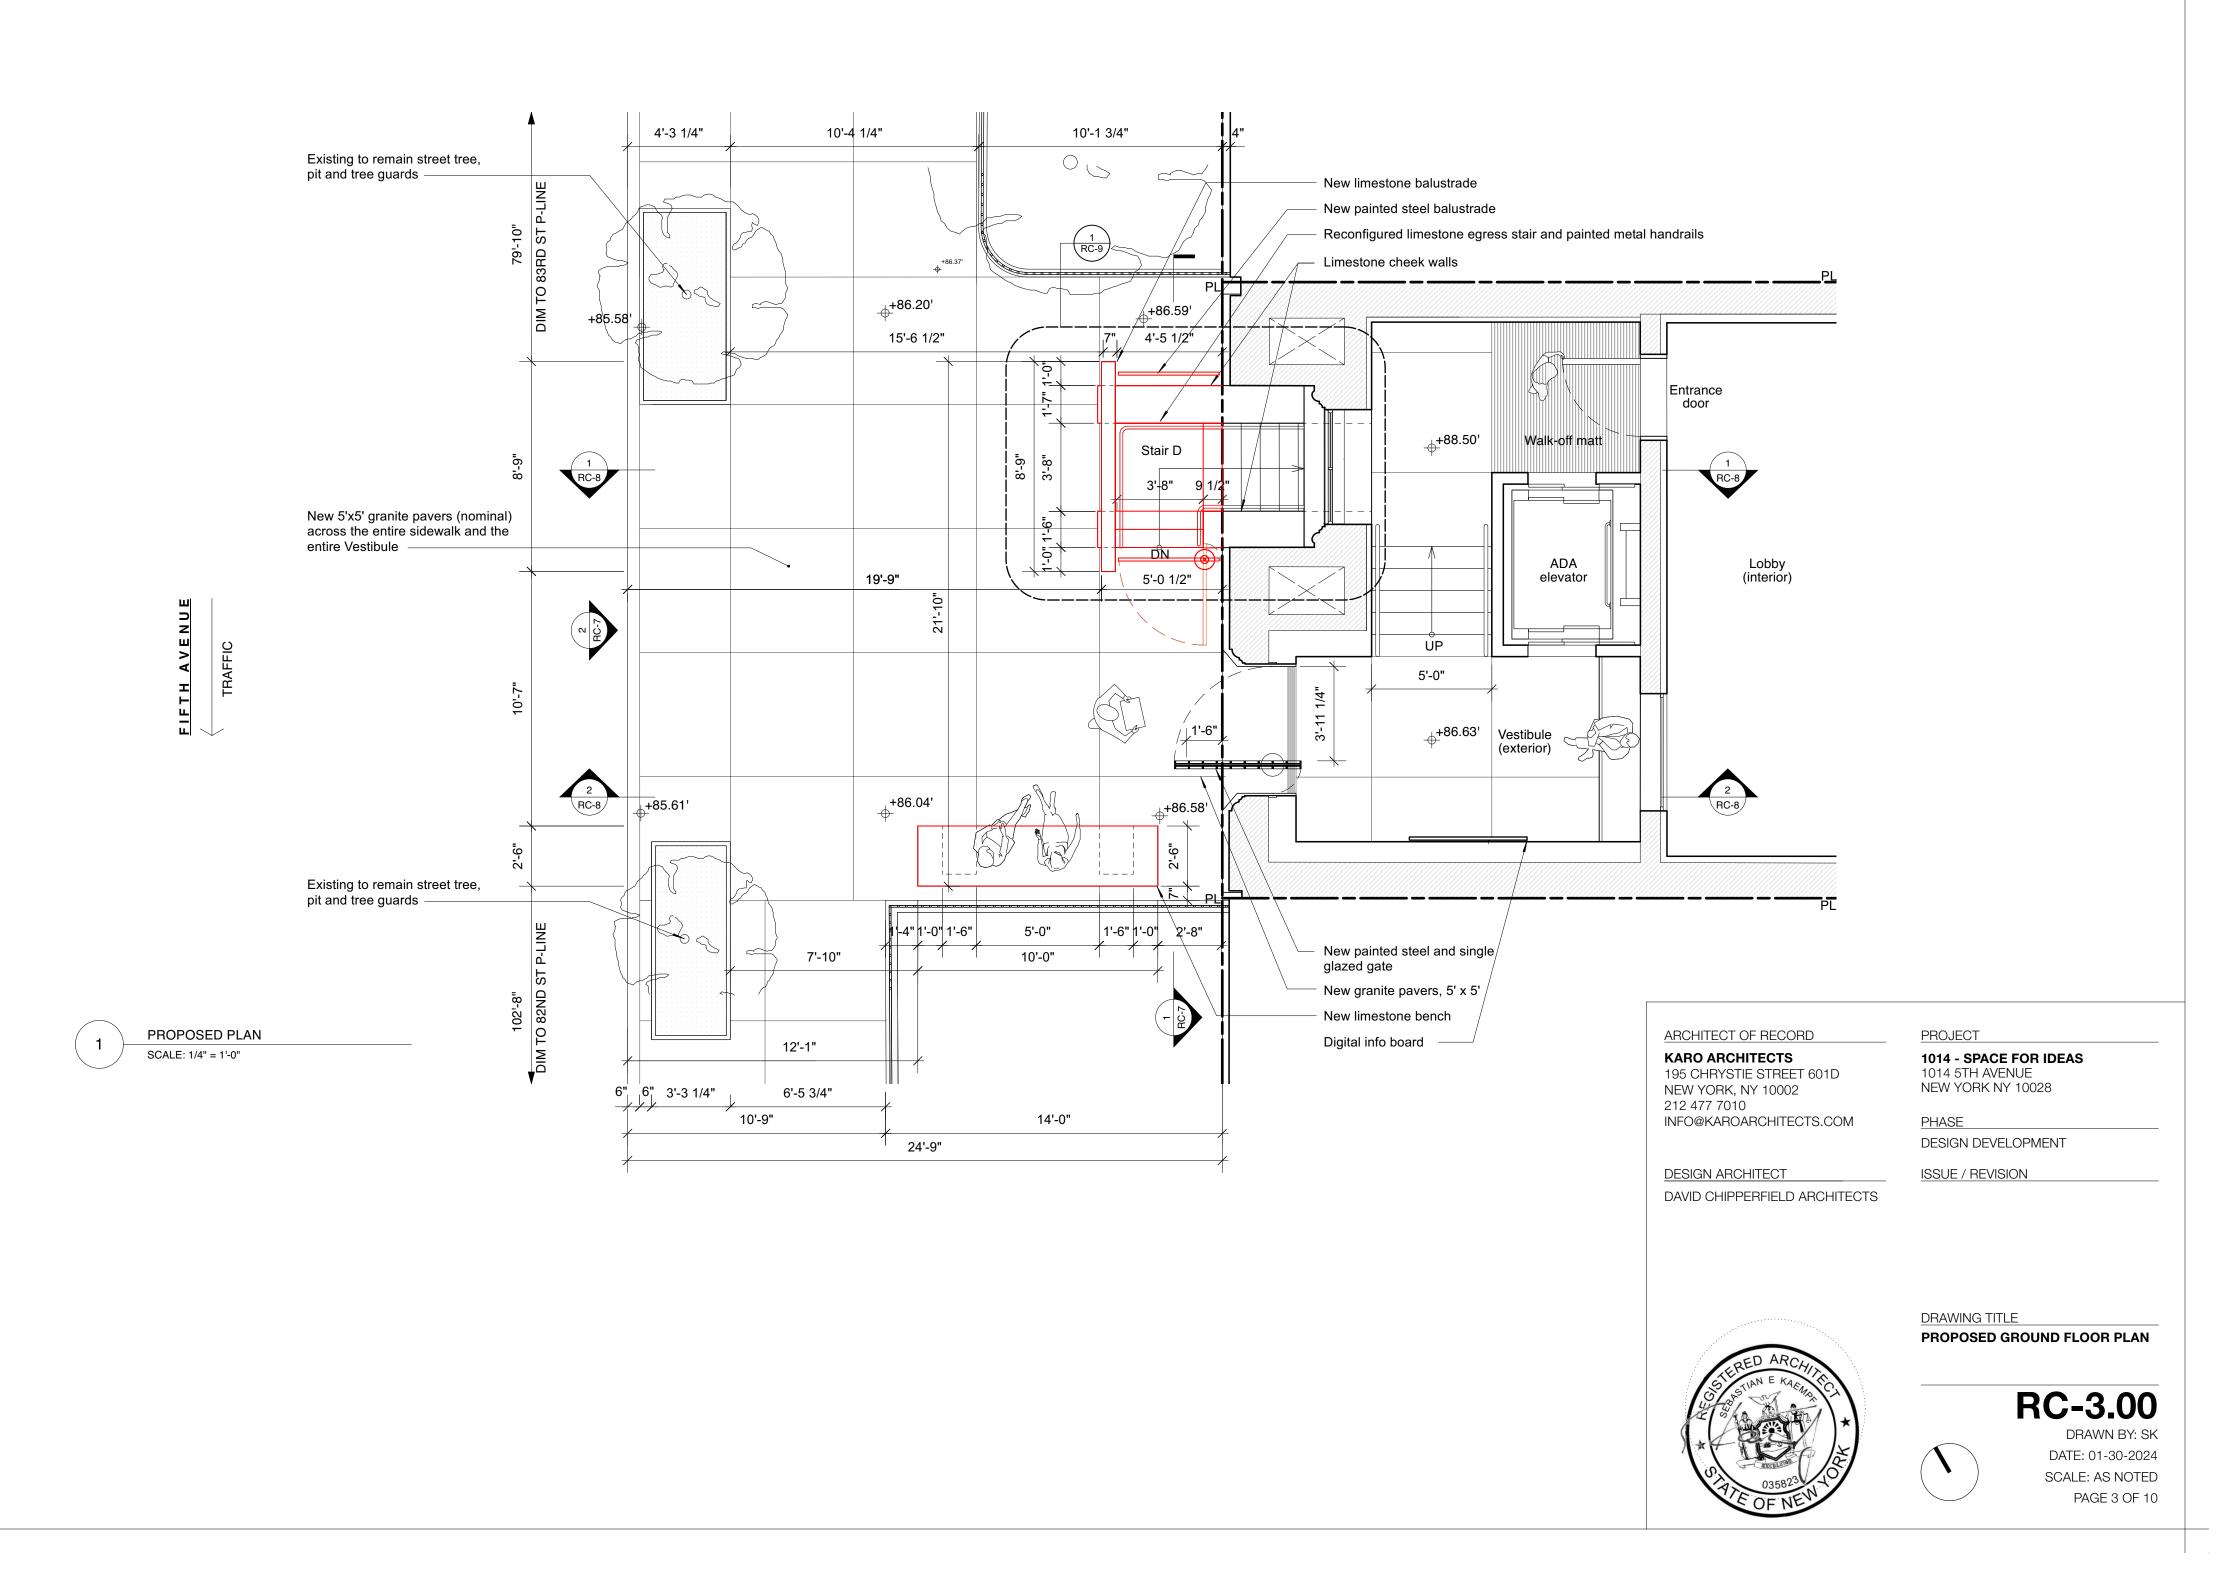

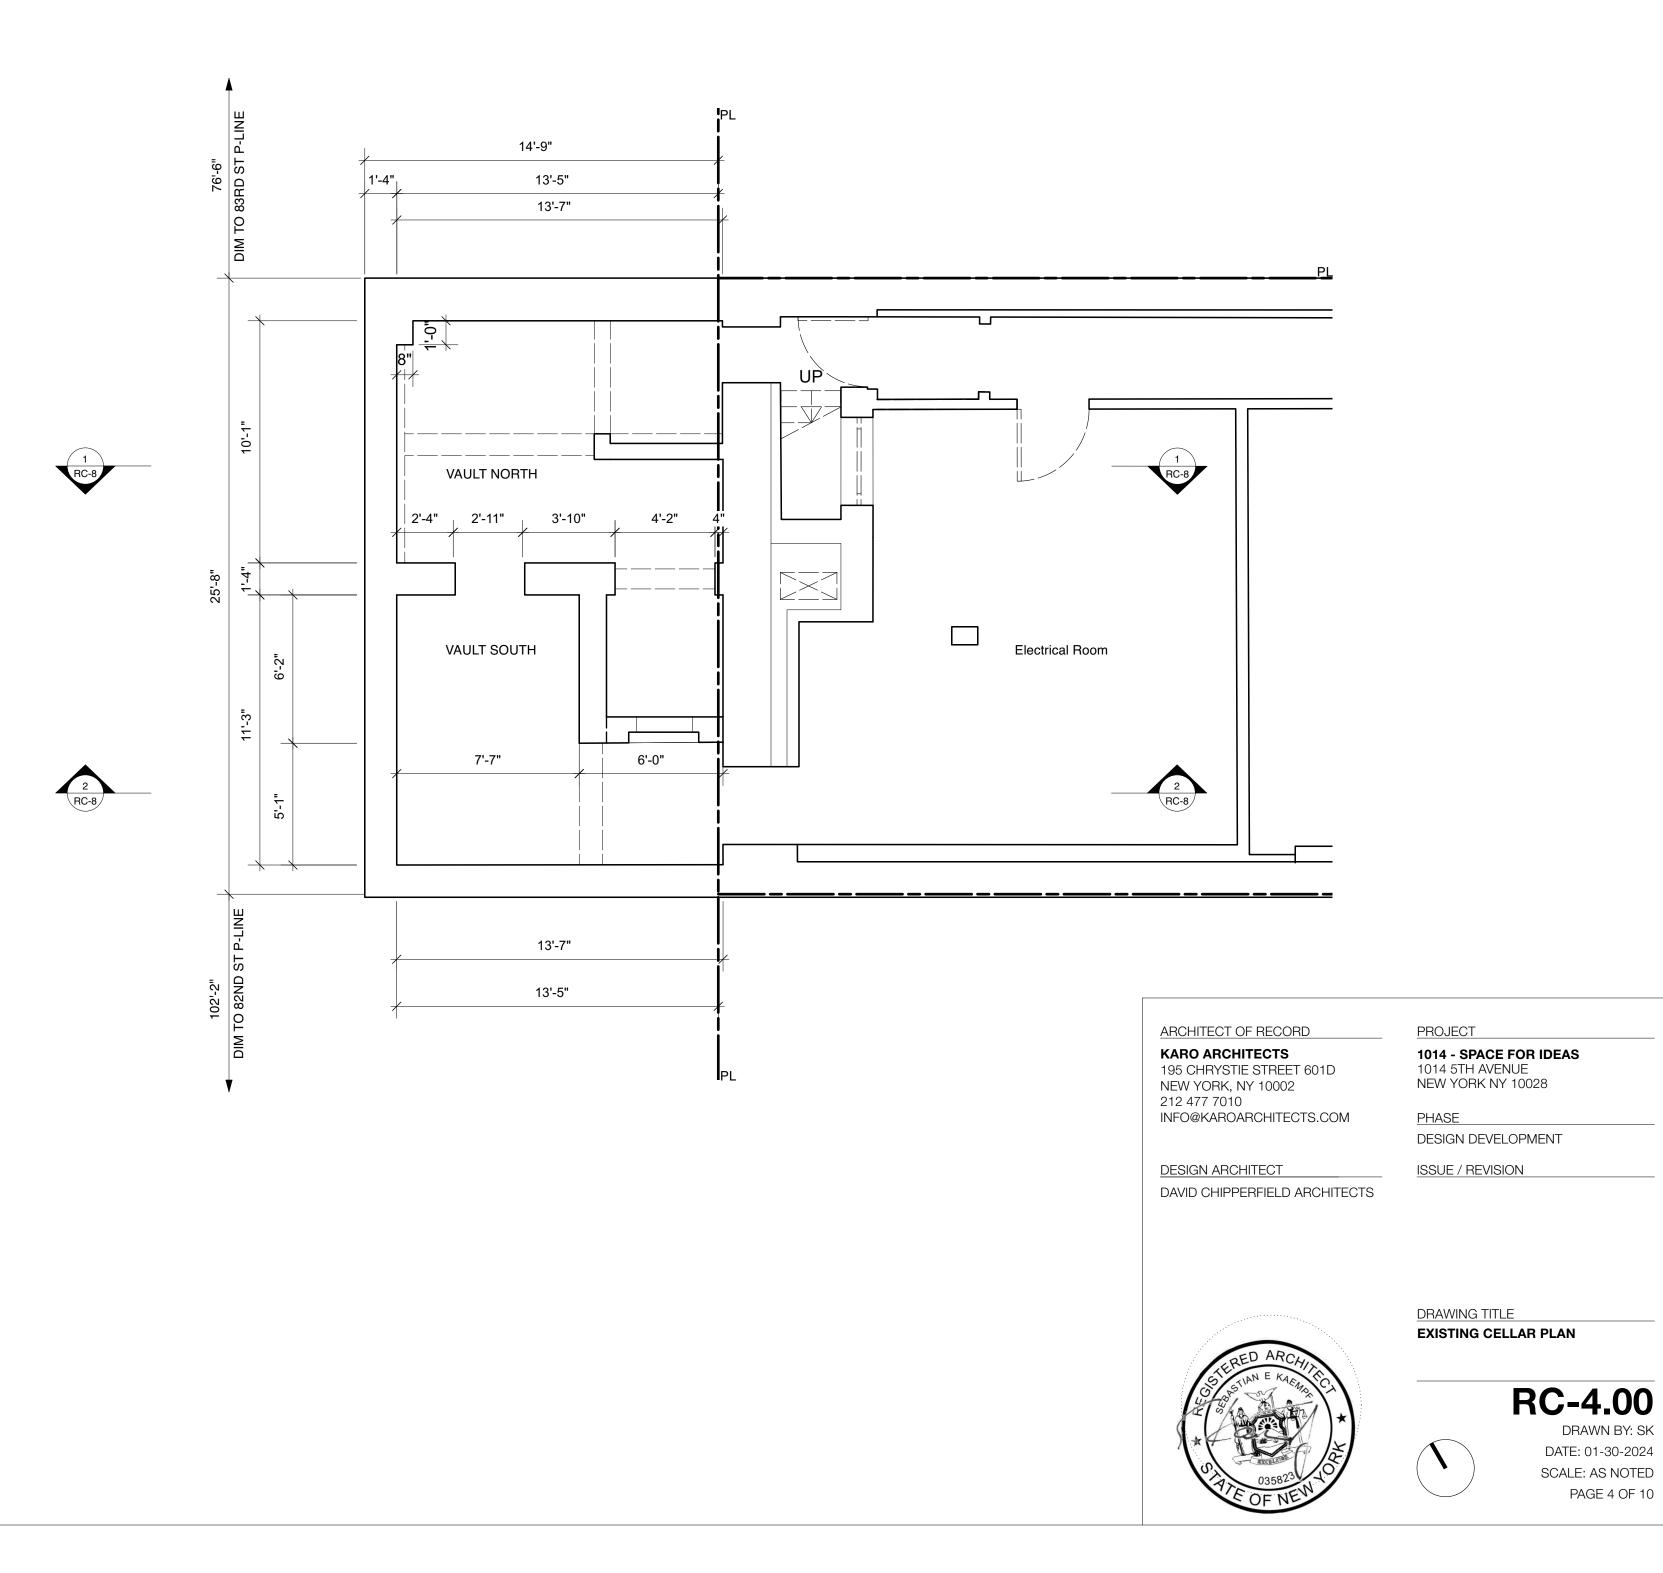

FIFTH AVENUE

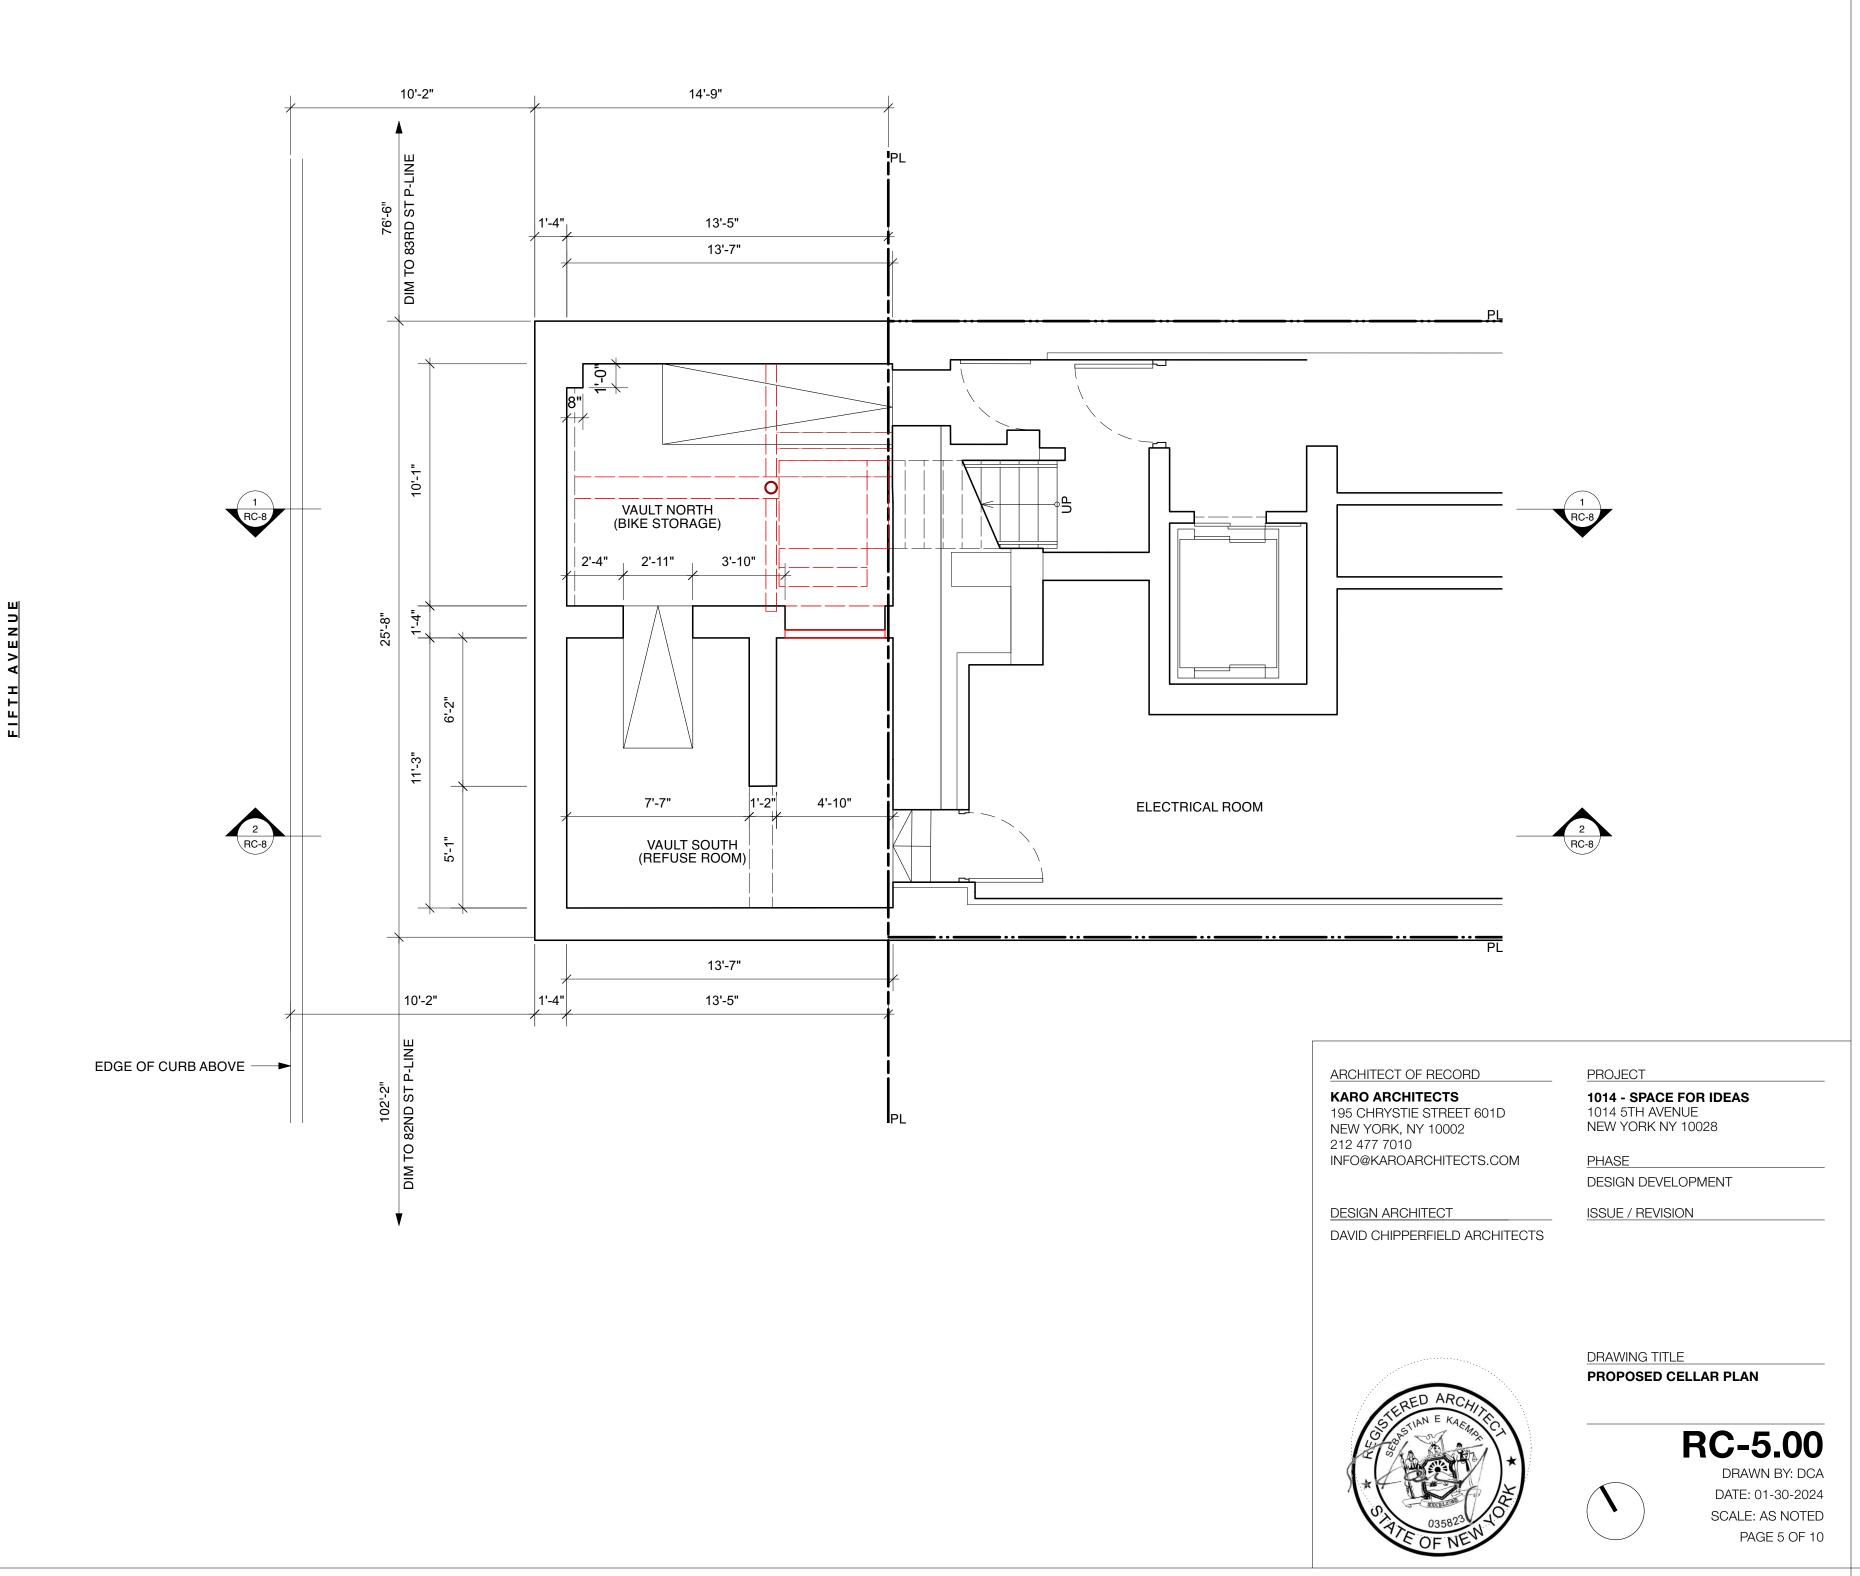




	¥ TC 85.83 BC 85.55 BC 85.55	N		86.3 + 86.29	86.0 ³	I I I I I I I BC 85.58 BC 85.32
				<i>RIM=80</i> 45.3'	5.10 - '' ''WE	85.5 WS BOX
			FLFTH AVENUE VARIABLE WIDTH R.O.W. (ASPAHLT ROADWAY) (TITLE VESTED APRIL 1838			APPROX LOC OF UG TELE LINE PER UTILITY MARKOUT) (SEE NOTE #3)
	FIFTH	AVENI	\$5.99 F	× 86.07 × 1 / / / / / / / / /		35.71 TC 85.54 BC 85.16
UE	(VARIABLE	WIDTH R.O.W.) T ROADWAY) RGEMENT / BOUNDARY IED APRIL 1838) 1'-0"			WATER MANHOLE CON. ED. MANHOLE CATCH BASINS CLEAN OUT STREET LIGHT GATE POST DECIDUOUS TREE & TRUNK	
	EXISTING PROPERTY LINE	<u> 124</u> <u>е</u> × 12 ^{3.45} е	EXISTING GRADE ELEVA EXIST. GRADE ELEVATIO ELEI CONVERTED TO NAVD 88 DATUM EEC RIM NAVD 88 (BOROUGH	N × (88 87.17)	SIZE CONIFEROUS TREE & TRUNK SIZE SANITARY/SEWER MANHOLE STEEL FACED_CONC.CURB ELECTRIC MANHOLE DEPRESSED RECORD MANHOLE	E R
ENUE D.W.) (Y) 1838)	EXIST. BOTTOM OF CURB ELEVATION EXIST. TOP OF WALL ELEVATION EXIST. BOTTOM OF WALL ELEVATION EXIST. FINISHED FLOOR ELEVATION	× BC 122.95 v × TW 123.45 c × BW 122.95 c × FF 123.45 c × FF 123.45 s	VAT SEWER DATUM) VAT INV. NAVD 88 (BOROUGH SEWER DATUM) CAT FIRE DEPARTMENT CONNECTION (F.D.C.) LE/ WATER VALVE TRI GAS VALVE CATI	1/110-125.00 (124.50)	EDGE OF CONVCATER MANHOLE CON. ED. MANHOLE EDGE OF PAVEMENT CATCH BASINS LANDSCAPED AREA CLEAN OUT FIRE DEPARTS FREET LIGHT CONNECTION TYPICAL GATE POST	
	EXIST. GARAGE FLOOR ELEVATION	× GF ^{123.45} S S D	ECIDUOUS TREE & TRUNK IZE ONIFEROUS TREE & TRUNK IZE TEEL FACED CONC. CURB EPRESSED CURB DGE OF CONC.		WATER LINE DECIDUOUS TREE & TRUNK SIZE 48" ELLIPTICAL PIPE CONIFEROUS TREE & TRUNK SIZE BUILDING STEEL FACED CONC. CURB EVIDENCE FOUND UNKNOWN TERMINUS	T# ₹} P# ₩₩ SFCC

EDGE OF PAVEMENT

UNKNOWN TERMINUS

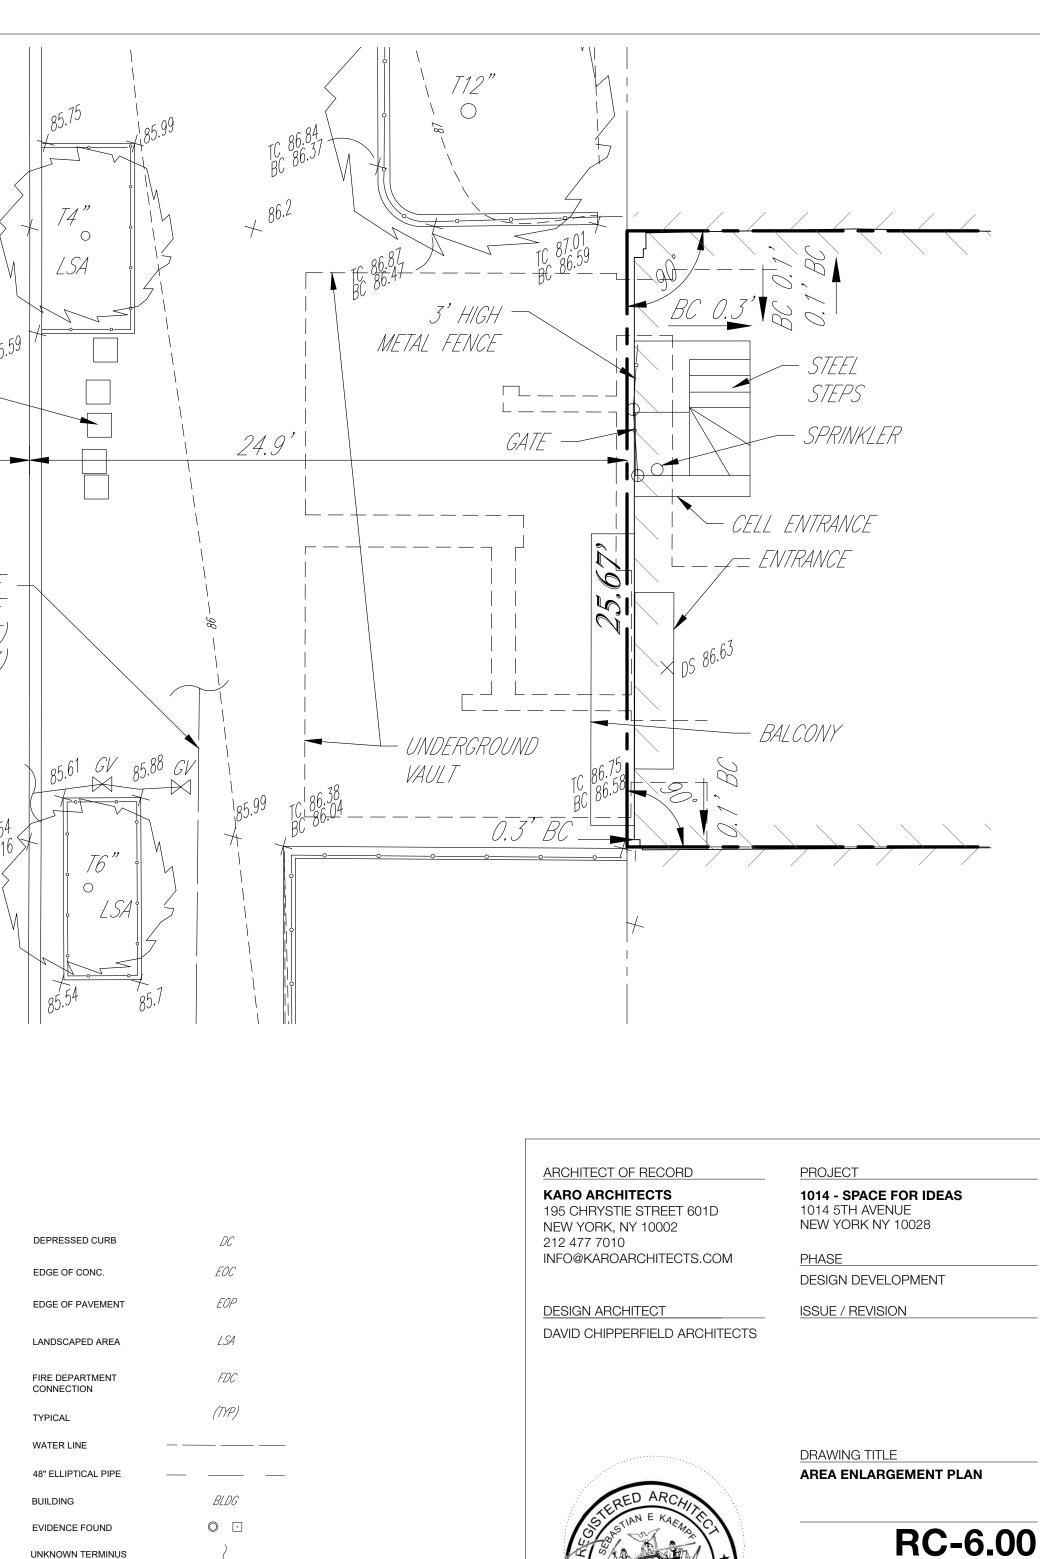

DRAWN BY: DCA DATE: 01-30-2024 SCALE: AS NOTED PAGE 6 OF 10

